



Development Variance Permit Application

Referral Form – RDCK File V26051

Date: March 16, 2026

You are requested to comment on the attached DEVELOPMENT VARIANCE PERMIT for potential effect on your agency's interests. We would appreciate your response WITHIN 30 DAYS (PRIOR TO APRIL 16, 2026). If no response is received within that time, it will be assumed that your agency's interests are unaffected.

LEGAL DESCRIPTION & GENERAL LOCATION:

2250 Glade Road, Glade, Electoral Area 'I'
 LOT B DISTRICT LOT 302A KOOTENAY DISTRICT PLAN EPP81680
 030-492-891

PRESENT USE AND PURPOSE OF PERMIT REQUESTED:

The property is presently being used for residential purposes and has been improved with a single detached dwelling and a 93m2 accessory building.

The accessory building was constructed without a valid building permit within the 2.5m side setback. The owner is seeking this variance to consider the accessory building to remain in this location. Due to the location of the existing residence, a variance to the farm residential footprint (FRF) regulations is also required.

Specifically, this Development Variance Permit (DVP) seeks to vary RDCK Zoning Bylaw No. 1675, 2004 as follows:

- 605(1) To reduce the required side setback from 2.5 metres to 1.3 metres, and;
- 2701(4) To allow a FRF depth of 90m whereas the bylaw requires a FRF depth of 60m.

AREA OF PROPERTY AFFECTED	ALR STATUS	ZONING	OCP
0.56 ha	yes	Agriculture 1 (AG1) in RDCK Zoning Bylaw No. 1675, 2004	Agriculture (AG) in Sentinel Mountain Official Community Plan Bylaw No. 2821, 2024

APPLICANT: Shane Aker

Please provide your response via email.

If your agency's interests are 'Unaffected' no further information is necessary. In all other cases, we would appreciate receiving additional information to substantiate your position and, if necessary, outline any conditions related to your position. Please note any legislation or official government policy which would affect our consideration of this permit.

If you are an RDCK commission member, do not respond via email. Your response is the commission's recommendation which staff will collect from the meeting minutes.

<input checked="" type="checkbox"/> MINISTRY OF TRANSPORTATION AND INFRASTRUCTURE <input checked="" type="checkbox"/> HABITAT BRANCH (Environment) <input checked="" type="checkbox"/> FRONTCOUNTER BC (MFLNRORD) <input checked="" type="checkbox"/> AGRICULTURAL LAND COMMISSION <input checked="" type="checkbox"/> REGIONAL AGROLOGIST <input checked="" type="checkbox"/> ARACHAEOLOGY BRANCH <input type="checkbox"/> ENERGY & MINES <input type="checkbox"/> MUNICIPAL AFFAIRS & HOUSING <input checked="" type="checkbox"/> INTERIOR HEALTH, HBE TEAM	REGIONAL DISTRICT OF CENTRAL KOOTENAY DIRECTORS FOR: <input type="checkbox"/> A <input type="checkbox"/> B <input type="checkbox"/> C <input type="checkbox"/> D <input type="checkbox"/> E <input type="checkbox"/> F <input type="checkbox"/> G <input type="checkbox"/> H <input checked="" type="checkbox"/> I <input type="checkbox"/> J <input type="checkbox"/> K ALTERNATIVE DIRECTORS FOR: <input type="checkbox"/> A <input type="checkbox"/> B <input type="checkbox"/> C <input type="checkbox"/> D <input type="checkbox"/> E <input type="checkbox"/> F <input type="checkbox"/> G <input type="checkbox"/> H <input type="checkbox"/> I <input type="checkbox"/> J <input type="checkbox"/> K <input checked="" type="checkbox"/> APHC AREA I <input checked="" type="checkbox"/> RDCK FIRE SERVICES <input checked="" type="checkbox"/> RDCK EMERGENCY SERVICES <input checked="" type="checkbox"/> RDCK BUILDING SERVICES <input type="checkbox"/> RDCK UTILITY SERVICES
---	--

<input type="checkbox"/> SCHOOL DISTRICT NO.	<input type="checkbox"/> RDCK RESOURCE RECOVERY
<input checked="" type="checkbox"/> WATER SYSTEM OR IRRIGATION DISTRICT	<input type="checkbox"/> RDCK REGIONAL PARKS
<input checked="" type="checkbox"/> UTILITIES (FORTIS, BC HYDRO, NELSON HYDRO, COLUMBIA POWER)	




The personal information on this form is being collected pursuant to *Regional District of Central Kootenay Planning Procedures and Fees Bylaw No. 2457, 2015* for the purpose of determining whether the application will affect the interests of other agencies or adjacent property owners. The collection, use and disclosure of personal information are subject to the provisions of FIPPA. Any submissions made are considered a public record for the purposes of this application. Only personal contact information will be removed. If you have any questions about the collection of your personal information, contact the Regional District Privacy Officer at 250.352.6665 (toll free 1.800.268.7325), info@rdck.bc.ca, or RDCK Privacy Officer, Box 590, 202 Lakeside Drive, Nelson, BC V1L 5R4.

RDCK Map



REGIONAL DISTRICT OF CENTRAL KOOTENAY
 Box 590, 202 Lakeside Drive,
 Nelson, BC V1L 5R4
 Phone: 1-800-268-7325 www.rdck.bc.ca
 maps@rdck.bc.ca

Legend

- Place Names
-  Electoral Areas
-  RDCK Streets
-  Cadastre - Property Lines

Map Scale:

1:18,056

Date: March 9, 2026



The mapping information shown are approximate representations and should only be used for reference purposes. The Regional District of Central Kootenay is not responsible for any errors or omissions on this map.

RDCK Map



REGIONAL DISTRICT OF CENTRAL KOOTENAY
 Box 590, 202 Lakeside Drive,
 Nelson, BC V1L 5R4
 Phone: 1-800-268-7325 www.rdck.bc.ca
 maps@rdck.bc.ca

Legend

- Electoral Areas
- RDCK Streets
- Cadastre - Property Lines
- Address Points

Map Scale:

1:4,514

Date: March 9, 2026







The mapping information shown are approximate representations and should only be used for reference purposes. The Regional District of Central Kootenay is not responsible for any errors or omissions on this map.

RDCK Map



REGIONAL DISTRICT OF CENTRAL KOOTENAY
Box 590, 202 Lakeside Drive,
Nelson, BC V1L 5R4
Phone: 1-800-268-7325 www.rdck.bc.ca
maps@rdck.bc.ca

Legend

-  Electoral Areas
-  RDCK Streets
-  Cadastre - Property Lines
-  Address Points

Map Scale:

1:2,257

Date: March 9, 2026





The mapping information shown are approximate representations and should only be used for reference purposes. The Regional District of Central Kootenay is not responsible for any errors or omissions on this map.

RDCK Map



REGIONAL DISTRICT OF CENTRAL KOOTENAY
Box 590, 202 Lakeside Drive,
Nelson, BC V1L 5R4
Phone: 1-800-268-7325 www.rdck.bc.ca
maps@rdck.bc.ca

Legend

-  Electoral Areas
-  RDCK Streets
-  Cadastre - Property Lines
-  Address Points
-  Agriculture
-  Environmental Reserve

Map Scale:

1:2,257

Date: March 9, 2026



The mapping information shown are approximate representations and should only be used for reference purposes. The Regional District of Central Kootenay is not responsible for any errors or omissions on this map.

RDCK Map



REGIONAL DISTRICT OF CENTRAL KOOTENAY
Box 590, 202 Lakeside Drive,
Nelson, BC V1L 5R4
Phone: 1-800-268-7325 www.rdck.bc.ca
maps@rdck.bc.ca

Legend

Zoning Class

- Agriculture
- Electoral Areas

- RDCK Streets
- Cadastre - Property Lines
- Address Points

Map Scale:

1:2,257

Date: March 9, 2026



The mapping information shown are approximate representations and should only be used for reference purposes. The Regional District of Central Kootenay is not responsible for any errors or omissions on this map.

RDCK Map








Vantor



REGIONAL DISTRICT OF CENTRAL KOOTENAY
Box 590, 202 Lakeside Drive,
Nelson, BC V1L 5R4
Phone: 1-800-268-7325 www.rdck.bc.ca
maps@rdck.bc.ca

Legend

-  Agriculture Land Reserve
-  Electoral Areas
-  RDCK Streets
-  Cadastre - Property Lines
-  Address Points

Map Scale:

1:2,257

Date: March 9, 2026



The mapping information shown are approximate representations and should only be used for reference purposes. The Regional District of Central Kootenay is not responsible for any errors or omissions on this map.

RDCK Map



REGIONAL DISTRICT OF CENTRAL KOOTENAY
Box 590, 202 Lakeside Drive,
Nelson, BC V1L 5R4
Phone: 1-800-268-7325 www.rdck.bc.ca
maps@rdck.bc.ca

Development Permit Areas

- Watercourse
- Wildfire

Legend

- Electoral Areas
- RDCK Streets
- Cadastre - Property Lines
- Address Points

Map Scale:

1:2,257

Date: March 9, 2026



The mapping information shown are approximate representations and should only be used for reference purposes. The Regional District of Central Kootenay is not responsible for any errors or omissions on this map.

Setback Requirements

605

- 1 Unless otherwise stated, no principal or accessory building or structure except a fence may be located within 7.5 metres of a front or exterior side lot line or within 2.5 metres of any other lot line.

Development Regulations

2701

1. The minimum lot size shall be 4.0 hectares in the Agricultural Land Reserve and 2.0 hectares outside the Agricultural Land Reserve.
- 1B. The maximum density is 2 Dwelling Units.
2. The maximum site coverage permitted shall be 35 percent of the lot area

Regional District of Central Kootenay Zoning Bylaw No. 1675, 2004 (Consolidated Version)
Page 99 of 155

unless an area not larger than 60 percent of the lot is covered with greenhouses.

3. The maximum Farm Residential Footprint shall be a maximum of 2000 square meters where one dwelling unit is permitted plus 500 square meters per additional permitted dwelling unit.
4. The maximum depth of the Farm Residential Footprint shall not exceed 60.0 metres measured from the Front Lot Line or Exterior Side Lot Line.



NW

154 1/4 N

NE


SHT METAL ROOFING
15# FELT OYEN
2x4 STRAPPING 20" o/c

2 16" x 3/8 GRK
TIMBER SCREWS PER POST TO BEAM

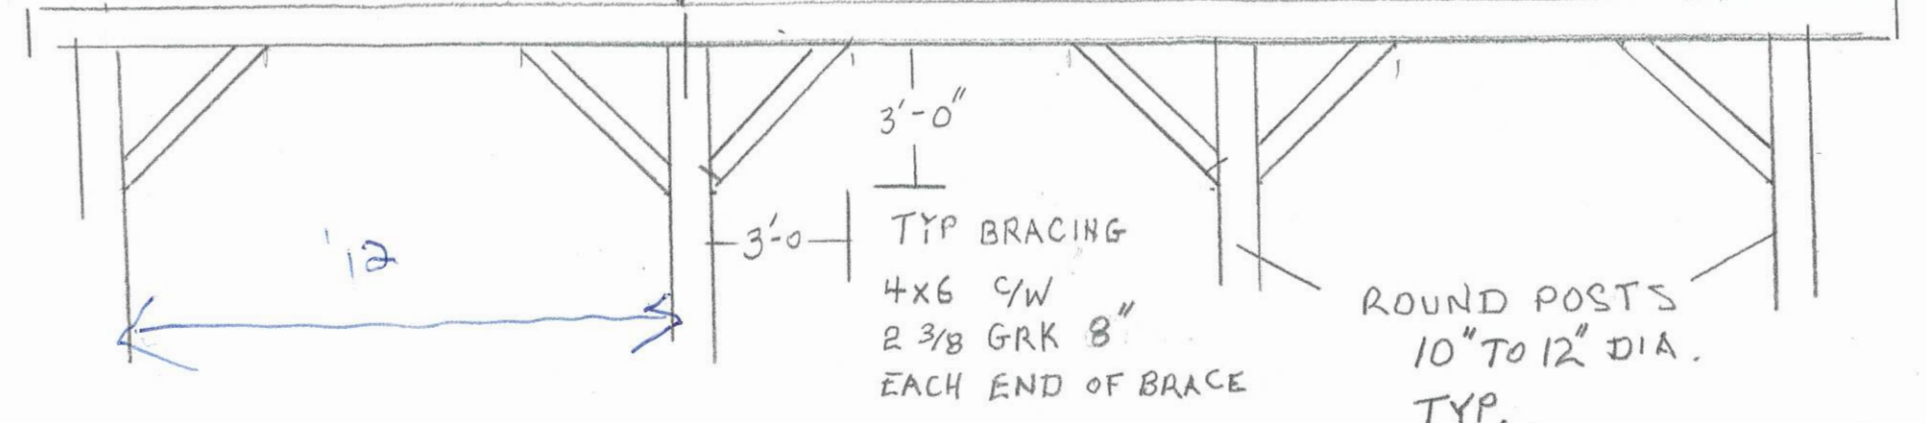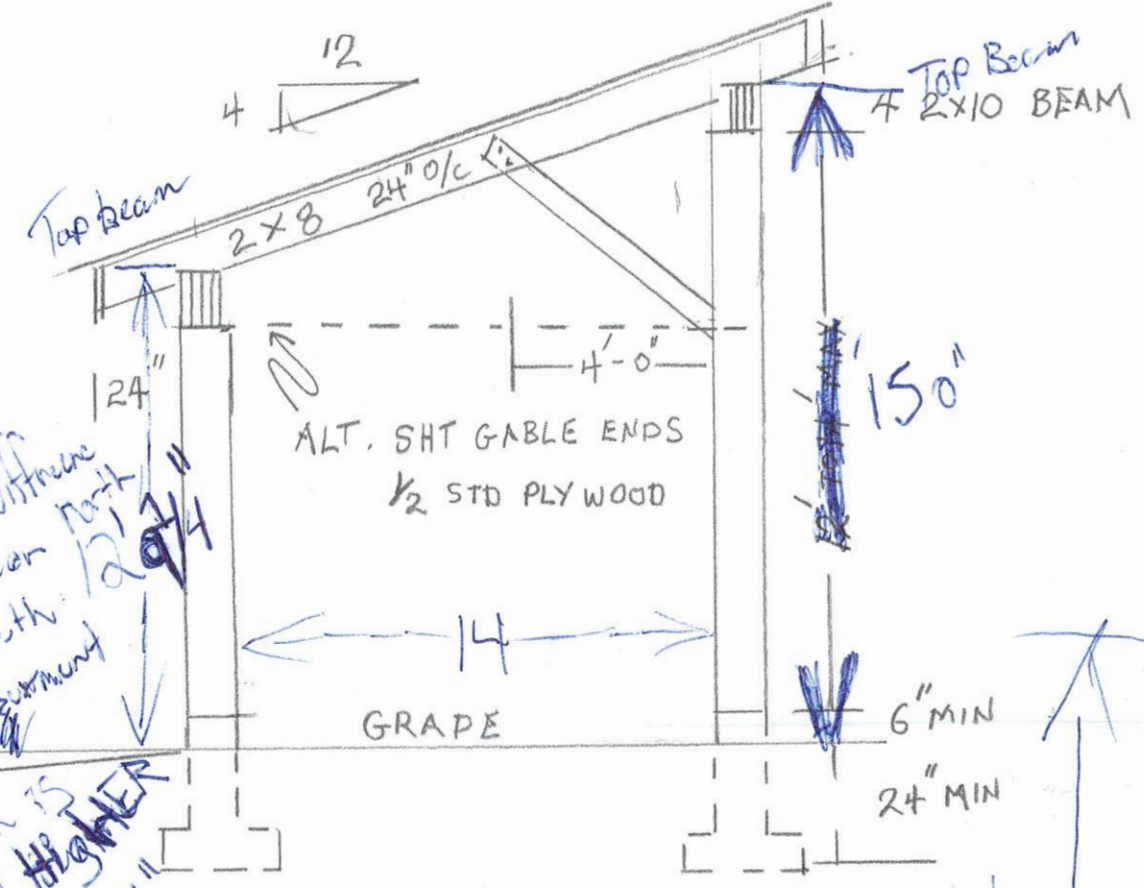


FRONT VIEW

END VIEW

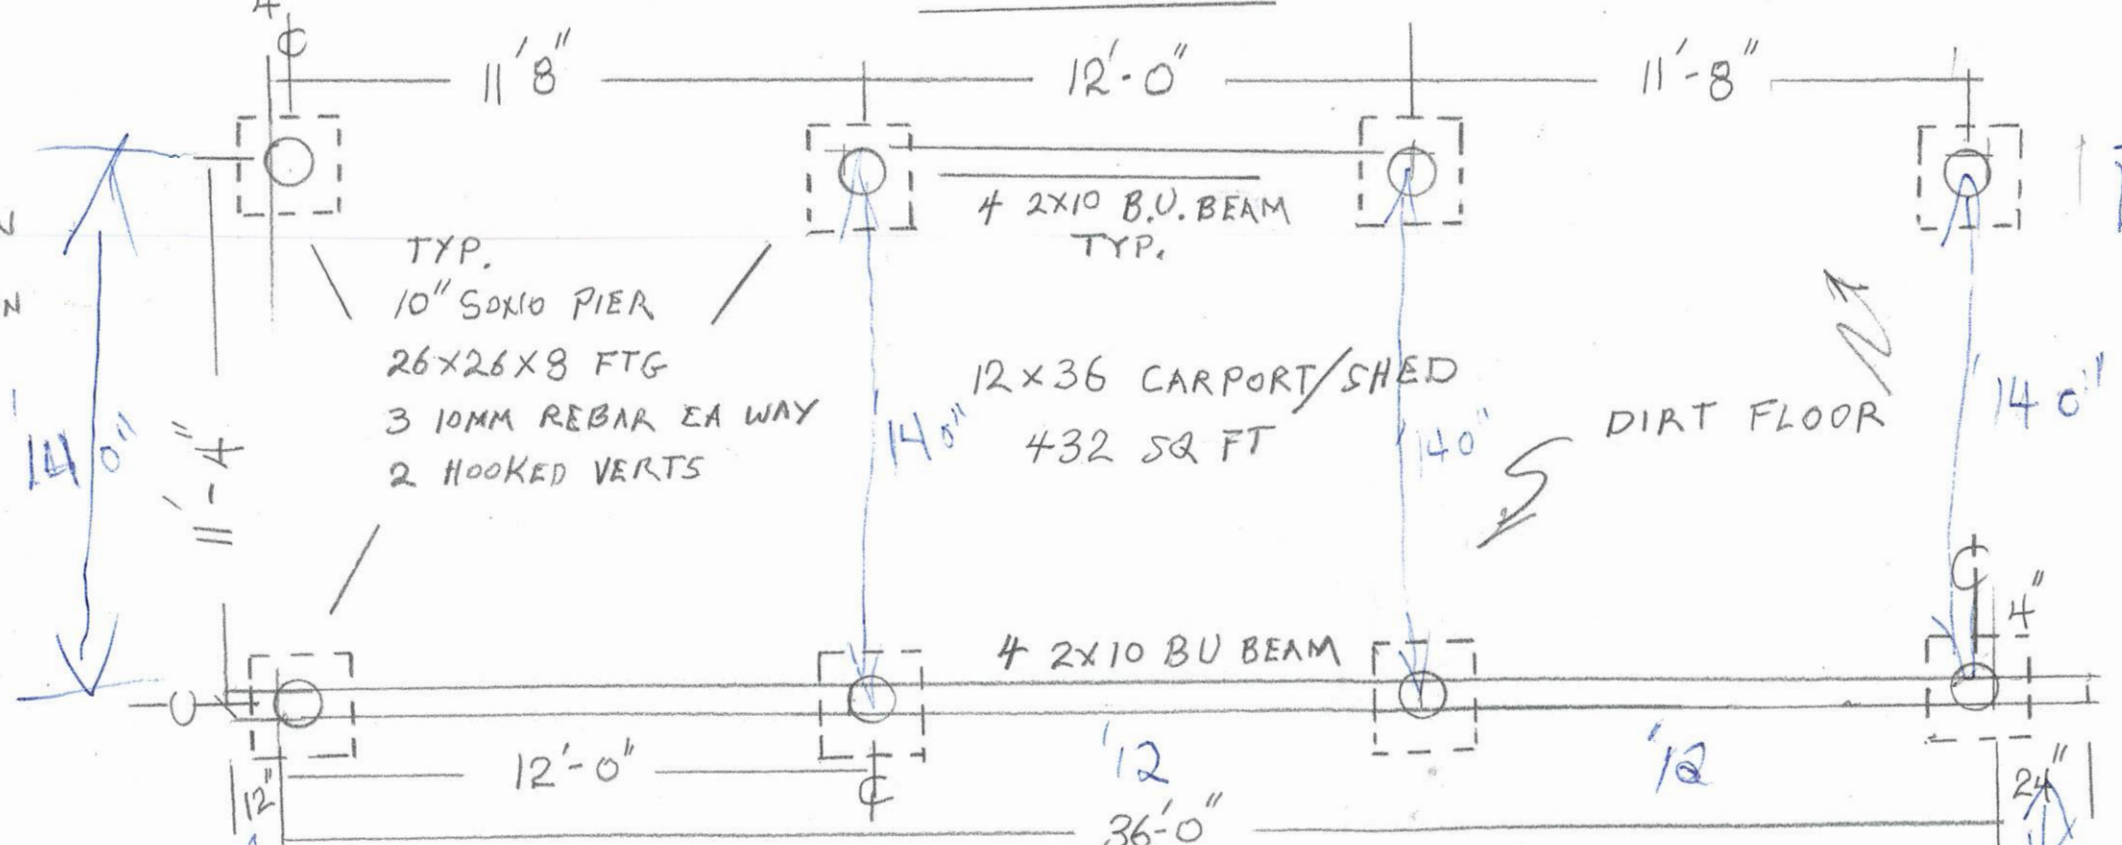

PLAN VIEW

BOTTOM OF POST DETAIL
1/4 x 1/2 FLAT BAR 20"
2 1/2 x 12 CARAGE BOLTS
THROUGH POSTS TYP.

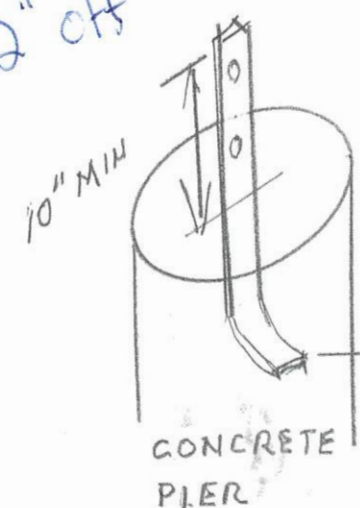

2" diff
Between
N South
measurement

North is
1" higher
@ 12' 10 1/4"

Still have to cut
1/2" off NW post

14 2x10
12


roof
S 2/12

SHANE ACKER	
TRACTOR SHED	
JULY 28 2024	1/4" = 1'-0"

SW



SE

SHT METAL ROOFING
 15# FELT OVER
 2x4 STRAPPING 20" O/C

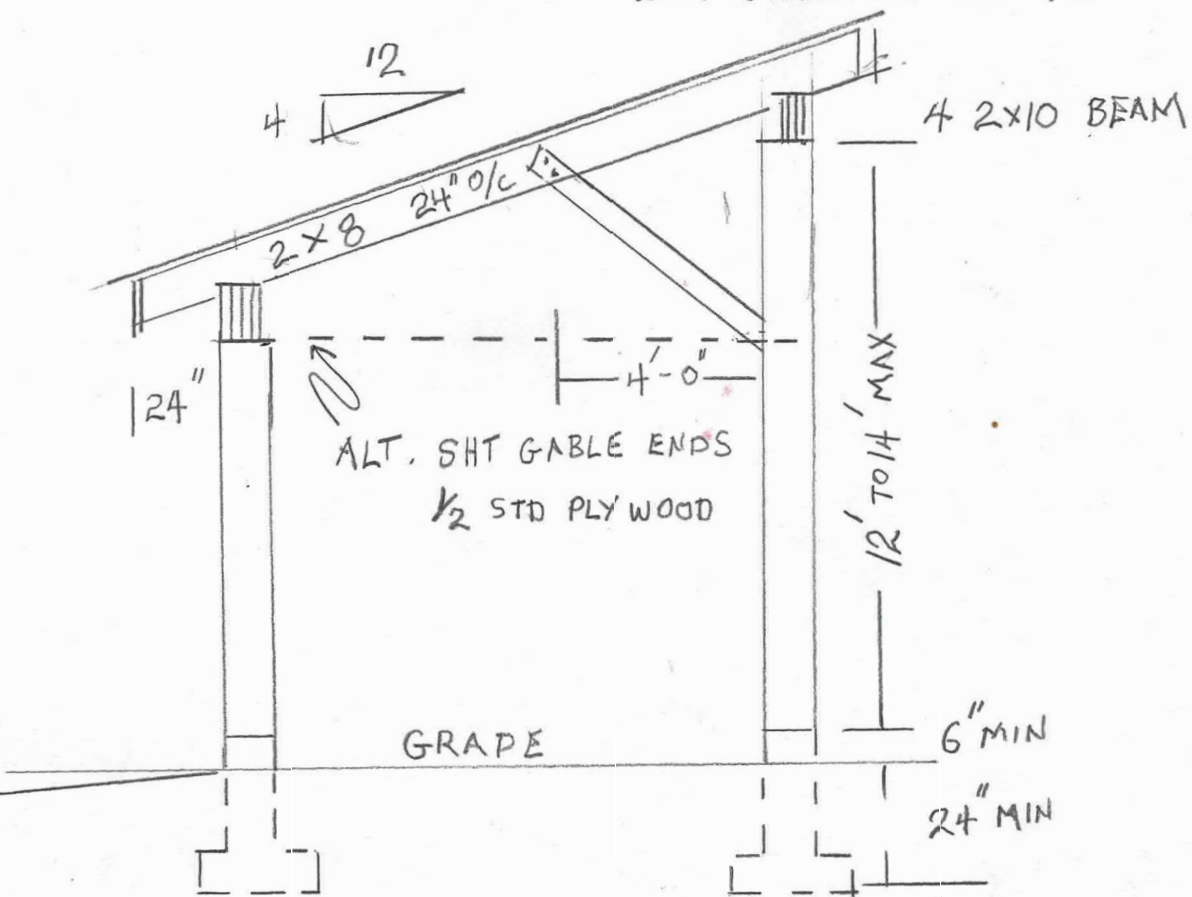


END VIEW

BOTTOM OF POST DETAIL
 1/4 x 1/2 FLAT BAR 20"
 2 1/2 x 12 CARAGE BOLTS
 THROUGH POSTS TYP.

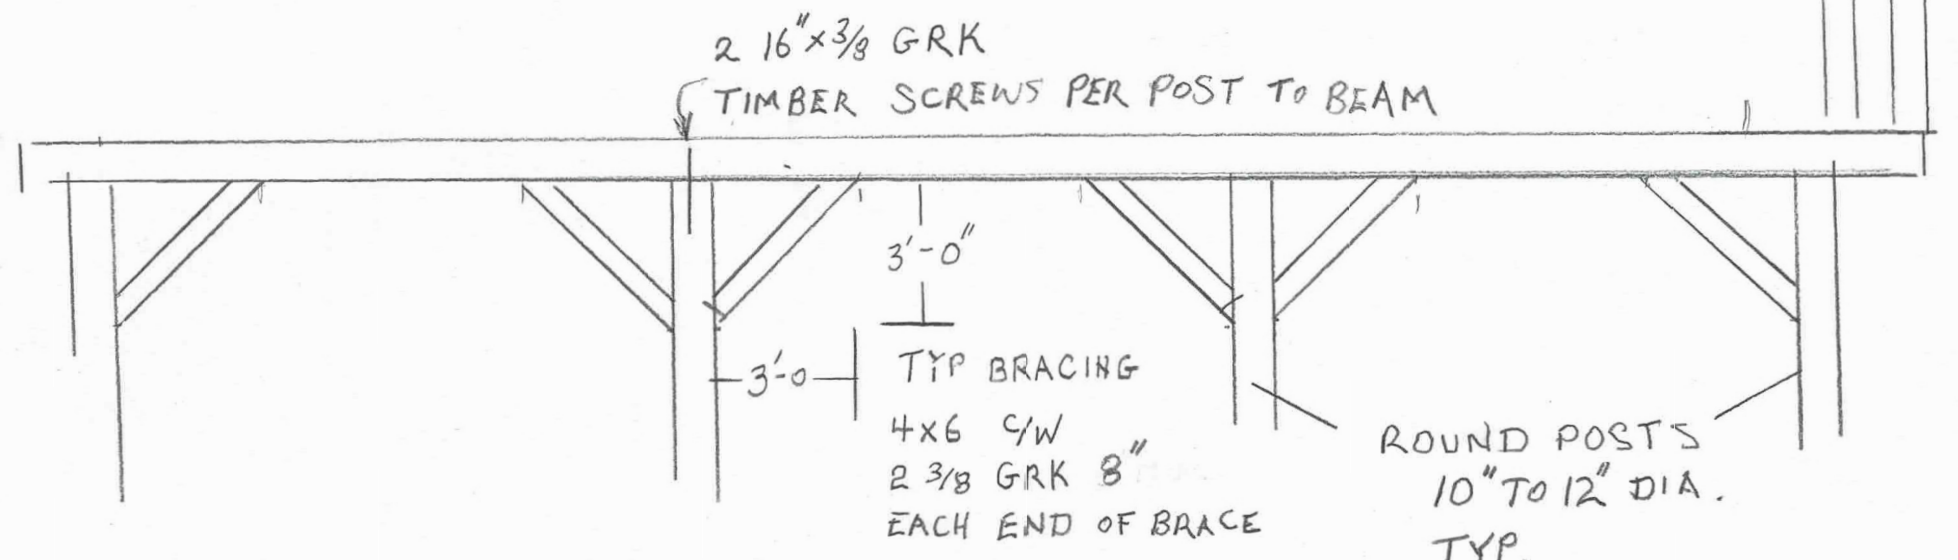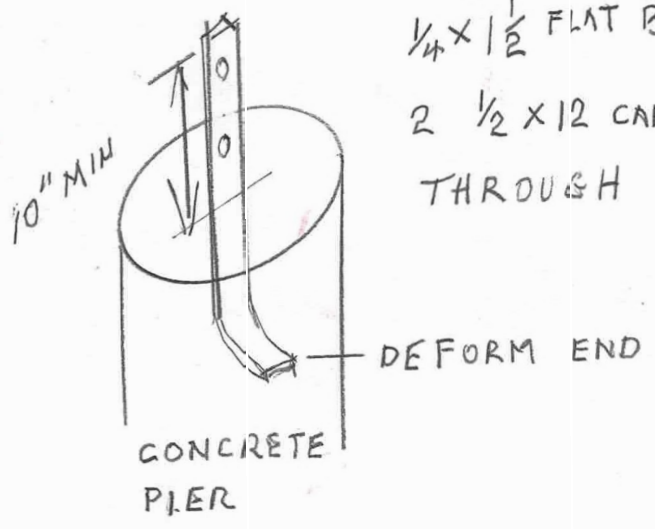

FRONT VIEW

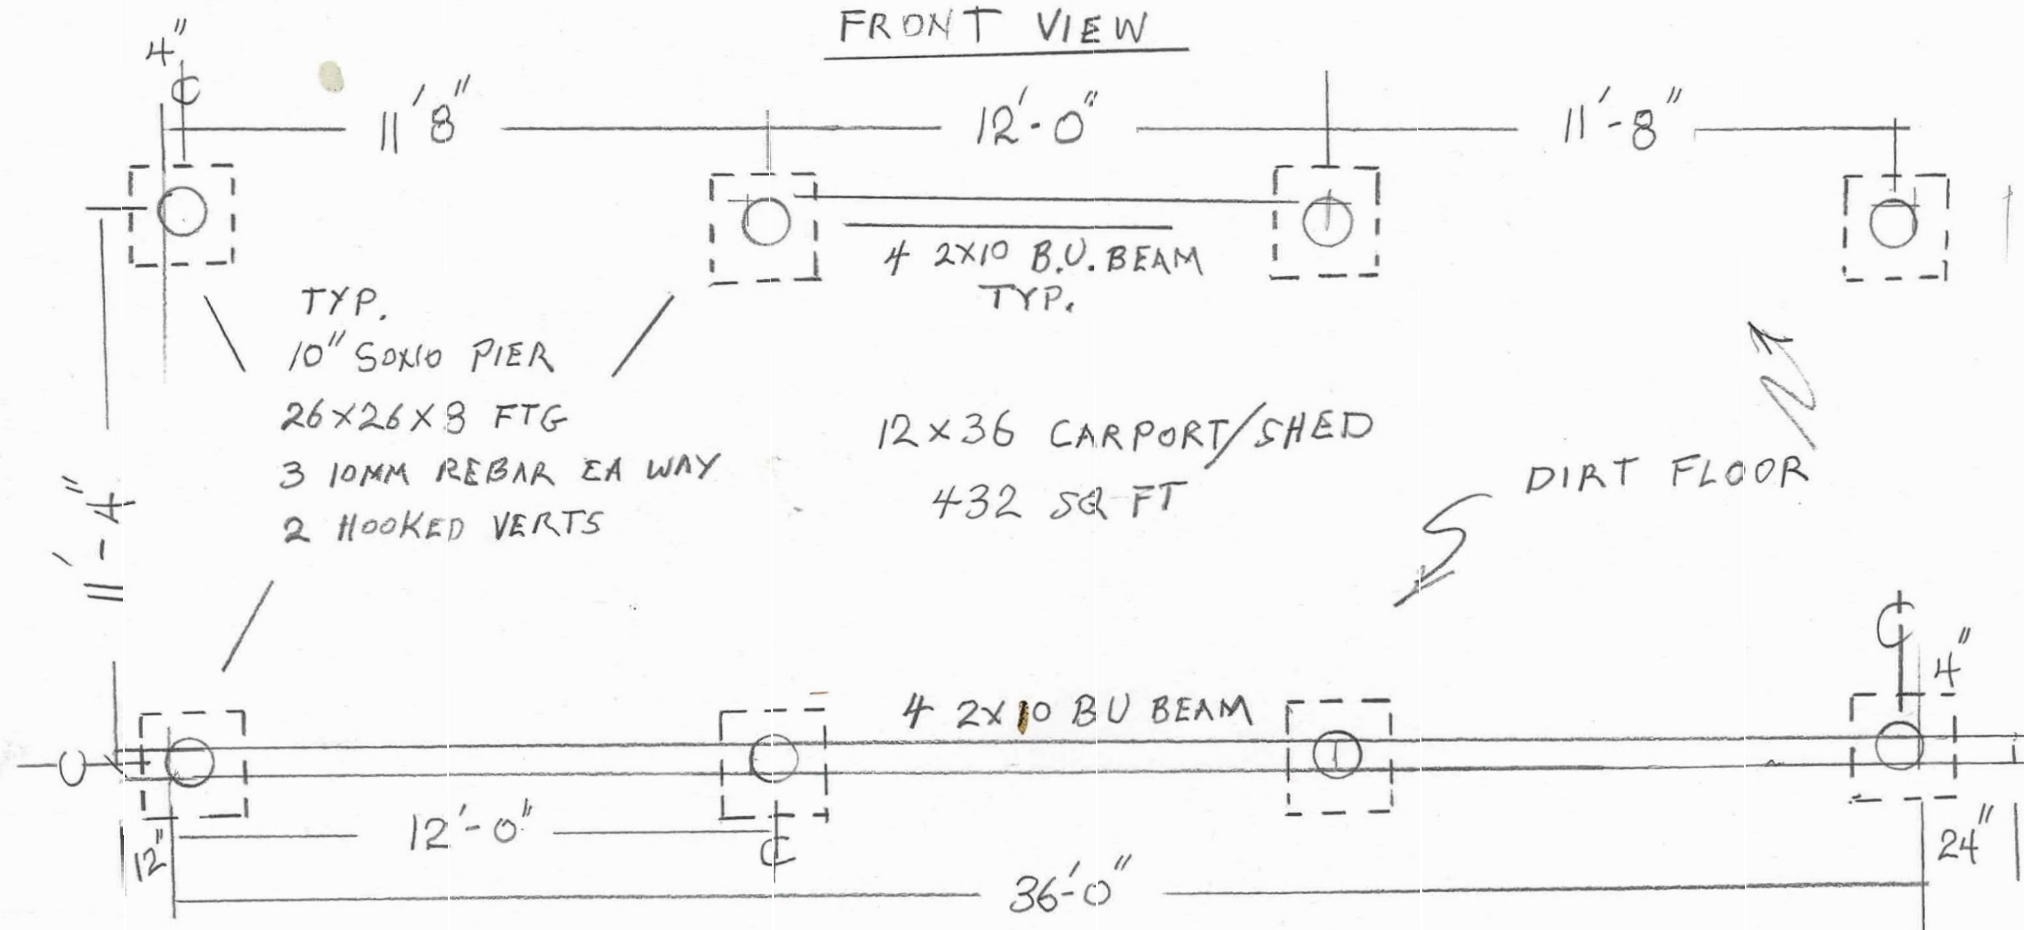

PLAN VIEW

SHANE ACKER	
TRACTOR SHED	
JULY 28 2024	1/4" = 1'-0"



RDCK Map

Legend

- Electoral Areas
- RDCK Streets
- Cadastre - Property Lines
- Address Points



Map Scale:

1:1,128



Date:
March 12, 2026

REGIONAL DISTRICT
OF CENTRAL KOOTENAY
Box 590, 202 Lakeside Drive,
Nelson, BC V1L 5R4
Phone: 1-800-268-7325
www.rdck.bc.ca
maps@rdck.bc.ca

The mapping information shown are approximate representations and should be used for reference purposes only.
The Regional District of Central Kootenay is not responsible for any errors or omissions on this map.

Sources: Esri, Vantor, Airbus DS, USGS, NGA, NASA, CGIAR, N Robinson, NCEAS, NLS, OS, NMA, Geodatastyrelsen,